


千葉都市計画事業弁天地区土地区画整理事業 換地図

町 名	弁天二丁目	街区番号	19	縮尺	1 : 500
-----	-------	------	----	----	---------

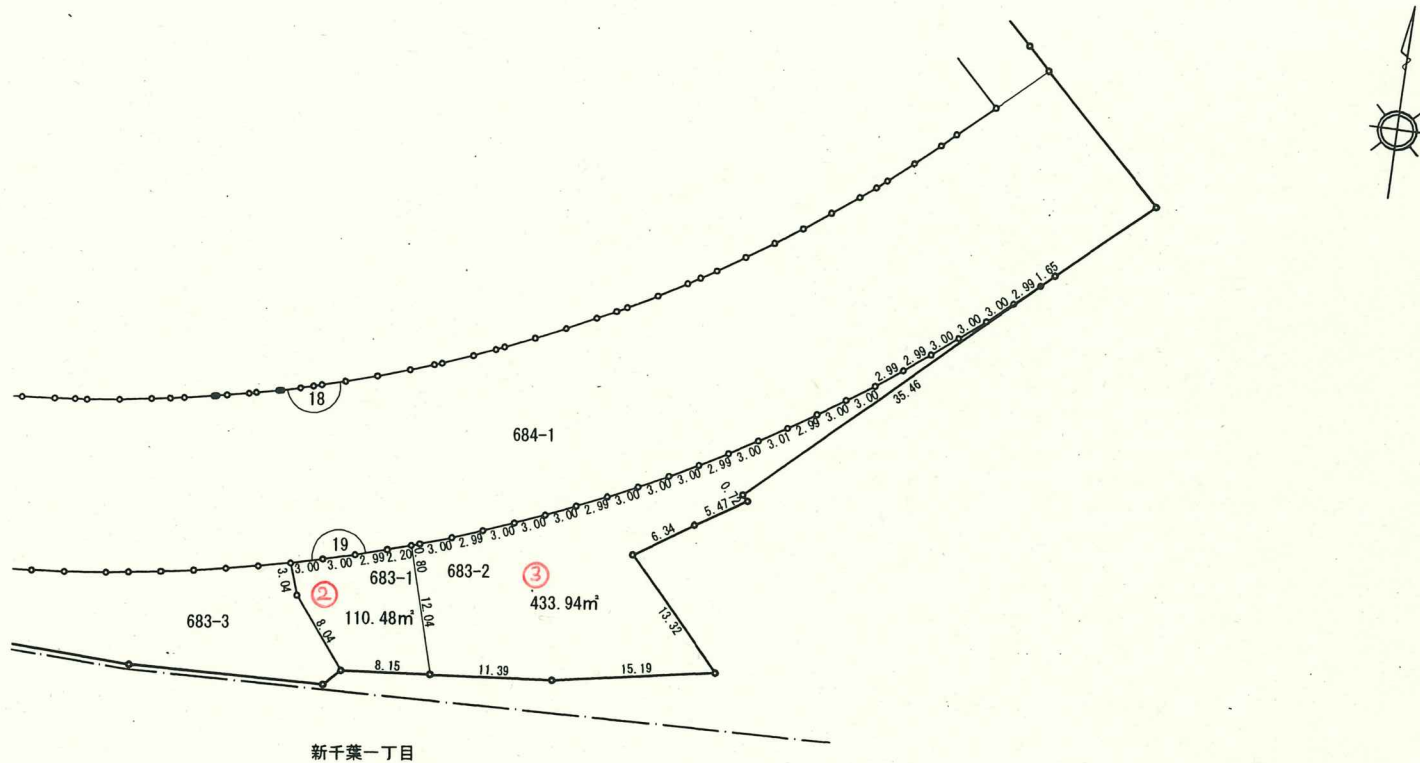

凡 例	
	換 地
	街区番号
	町 界
10-1	地 番
20.14	辺長 (m)

現場名: 弁天地区出来形確認測量

倍橫距法面積計算書

地番 点名	19-1							
	X	Y	距離	方向角	緯距	經距	倍橫距	倍面積
19-001	-43209.544	25842.789	2.502	92° 09' 12"	-0.295	-2.084	-2.084	0.614780
19-035	-43209.638	25845.289	15.261	88° 24' 56"	-0.094	2.500	-1.668	0.156792
19-034	-43209.216	25860.544	3.048	341° 30' 20"	0.422	15.255	16.087	6.788714
19-008	-43206.325	25859.577	2.998	256° 32' 18"	2.891	-0.967	30.375	87.814125
19-007	-43207.023	25856.661	3.002	257° 40' 19"	-0.698	-2.916	26.492	-18.491416
19-006	-43207.664	25853.728	2.999	258° 43' 53"	-0.641	-2.933	20.643	-13.232163
19-005	-43208.250	25850.787	3.000	259° 54' 13"	-0.586	-2.941	14.769	-8.654634
19-004	-43208.776	25847.833	2.998	260° 55' 16"	-0.526	-2.954	8.874	-4.667724
19-003	-43209.249	25844.873	2.105	261° 56' 35"	-0.473	-2.960	2.960	-1.400080
							倍面積	48.928394
							面積	24.4641970

現場名：弁天地区出来形確認測量

倍橫距法面積計算書

地番 点名	19-2 X	Y	距離	方向角	緯距	經距	倍橫距	倍面積
19-008	-43206.325	25859.577	3.048	161° 30' 20"	-0.761	-2.902	-2.902	2.208422
19-034	-43209.216	25860.544	8.048	141° 42' 02"	-2.891	0.967	-4.837	13.983767
K. 67	-43215.532	25865.532	8.154	84° 39' 33"	-6.316	4.988	1.118	-7.061288
K. 66-1	-43214.773	25873.651	12.043	343° 59' 17"	0.759	8.119	14.225	10.796775
19-036	-43203.197	25870.329	2.200	251° 59' 36"	11.576	-3.322	19.022	220.198672
19-011	-43203.877	25868.237	2.999	253° 04' 32"	-0.680	-2.092	13.608	-9.253440
19-010	-43204.750	25865.368	3.001	254° 15' 52"	-0.873	-2.869	8.647	-7.548831
19-009	-43205.564	25862.479	3.000	255° 18' 22"	-0.814	-2.889	2.889	-2.351646
							倍 面 積	220.972431
							面 積	110.4862155

現場名: 弁天地区出来形確認測量

倍横距法面積計算書

地番 点名	19-3 X	Y	距離	方向角	緯距	經距	倍横距	倍面積
19-036	-43203.197	25870.329	12.043	163° 59' 17"	-0.247	-0.762	-0.762	0.188214
K. 66-1	-43214.773	25873.651	11.398	84° 40' 45"	-11.576	3.322	1.798	-20.813648
K. 66	-43213.716	25885.000	15.193	79° 31' 46"	1.057	11.349	16.469	17.407733
K. 65	-43210.955	25899.940	13.329	316° 58' 01"	2.761	14.940	42.758	118.054838
K. 64	-43201.212	25890.844	6.341	56° 32' 26"	9.743	-9.096	48.602	473.529286
K. 63	-43197.716	25896.134	5.474	58° 10' 16"	3.496	5.290	44.796	156.606816
K. 62	-43194.829	25900.785	0.724	315° 13' 26"	2.887	4.651	54.737	158.025719
K. 61	-43194.315	25900.275	35.462	47° 11' 55"	0.514	-0.510	58.878	30.263292
19-002	-43170.220	25926.294	1.653	227° 22' 44"	24.095	26.019	84.387	2033.304765
19-033	-43171.339	25925.078	2.999	228° 39' 02"	-1.119	-1.216	109.190	-122.183610
19-032	-43173.320	25922.827	3.001	229° 13' 44"	-1.981	-2.251	105.723	-209.437263
19-031	-43175.280	25920.554	3.000	230° 30' 18"	-1.960	-2.273	101.199	-198.350040
19-030	-43177.188	25918.239	3.001	231° 46' 42"	-1.908	-2.315	96.611	-184.333788
19-029	-43179.045	25915.881	2.994	232° 57' 15"	-1.857	-2.358	91.938	-170.728866
19-028	-43180.849	25913.491	2.995	234° 01' 59"	-1.804	-2.390	87.190	-157.290760
19-027	-43182.608	25911.067	3.002	235° 11' 16"	-1.759	-2.424	82.376	-144.899384
19-026	-43184.322	25908.602	3.002	236° 21' 27"	-1.714	-2.465	77.487	-132.812718
19-025	-43185.985	25906.103	2.995	237° 17' 49"	-1.663	-2.499	72.523	-120.605749
19-024	-43187.603	25903.583	3.017	238° 39' 54"	-1.618	-2.520	67.504	-109.221472
19-023	-43189.172	25901.006	3.004	239° 38' 41"	-1.569	-2.577	62.407	-97.916583
19-022	-43190.690	25898.414	2.995	240° 44' 21"	-1.518	-2.592	57.238	-86.887284
19-021	-43192.154	25895.801	3.001	241° 54' 22"	-1.464	-2.613	52.033	-76.176312
19-020	-43193.567	25893.154	3.000	243° 03' 33"	-1.413	-2.647	46.773	-66.090249
19-019	-43194.926	25890.480	3.001	244° 05' 33"	-1.359	-2.674	41.452	-56.333268
19-018	-43196.237	25887.781	2.995	245° 18' 33"	-1.311	-2.699	36.079	-47.299569
19-017	-43197.488	25885.060	3.005	246° 27' 48"	-1.251	-2.721	30.659	-38.354409
19-016	-43198.688	25882.305	3.000	247° 32' 46"	-1.200	-2.755	25.183	-30.219600

地番 点名	19-3 X	Y	距離	方向角	緯距	經距	倍橫距	倍面積
19-015	-43199.834	25879.532	3.000	248° 36' 36"	-1.146	-2.773	19.655	-22.524630
19-014	-43200.928	25876.739	2.997	249° 43' 58"	-1.094	-2.793	14.089	-15.413366
19-013	-43201.966	25873.928	3.003	250° 52' 16"	-1.038	-2.811	8.485	-8.807430
19-012	-43202.950	25871.091	0.801	252° 02' 24"	-0.984	-2.837	2.837	-2.791608
							倍面積	867.889057
							面積	433.9445285