


千葉都市計画事業弁天地区土地区画整理事業 換地図

町 名	弁天一丁目	街区番号	4	縮尺	1 : 500
-----	-------	------	---	----	---------

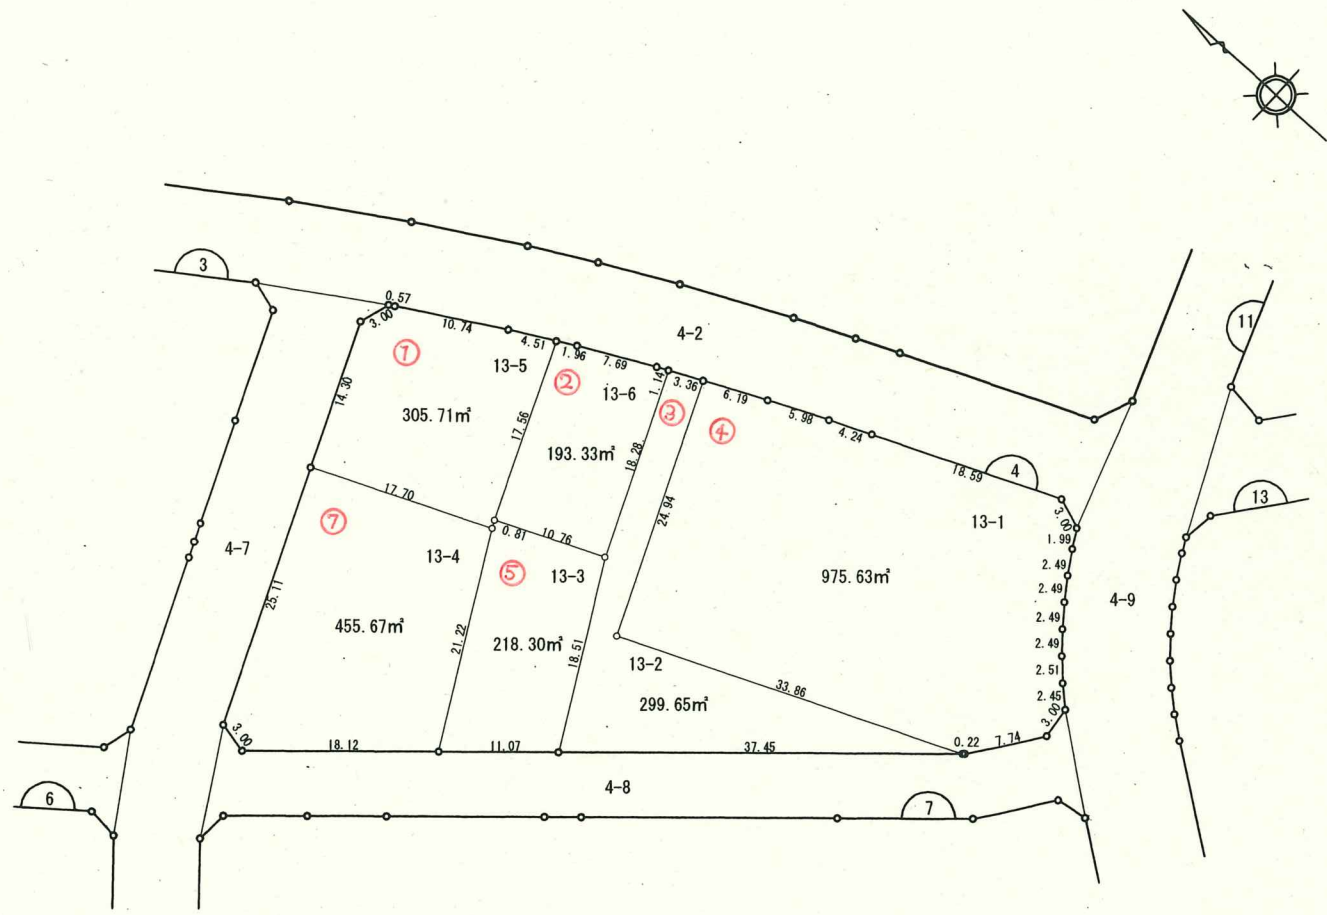

凡 例	
	換 地
	街区番号
	町 界
10-1	地 番
20.14	辺長 (m)

現場名:弁天地区出来形確認測量

倍横距法面積計算書

地番 点名	4-1 X	Y	距離	方向角	緯距	經距	倍橫距	倍面積
4-002	-42965.841	25563.757	3.003	286° 40' 45"	0.492	-0.303	-0.303	-0.149076
4-001	-42964.979	25560.880	14.308	246° 13' 34"	0.862	-2.877	-3.483	-3.002346
4-026	-42970.747	25547.786	17.700	156° 10' 30"	-5.768	-13.094	-19.454	112.210672
4-033	-42986.939	25554.936	0.813	63° 24' 12"	-16.192	7.150	-25.398	411.244416
4-034	-42986.575	25555.663	17.563	66° 17' 13"	0.364	0.727	-17.521	-6.377644
4-027	-42979.512	25571.743	4.510	330° 49' 55"	7.063	16.080	-0.714	-5.042982
4-010	-42975.574	25569.545	10.746	329° 18' 31"	3.938	-2.198	13.168	51.855584
4-009	-42966.333	25564.060	0.578	328° 22' 23"	9.241	-5.485	5.485	50.686885
							倍 面 積	611.425509
							面 積	305.7127545

現場名：弁天地区出来形確認測量

倍横距法面積計算書

地番 点名	X	Y	距離	方向角	緯距	經距	倍橫距	倍面積
4-027	-42979.512	25571.743	17.563	246° 17' 13"	1.721	-0.945	-0.945	-1.626345
4-034	-42986.575	25555.663	10.766	156° 10' 31"	-7.063	-16.080	-17.970	126.922110
4-032	-42996.424	25560.012	18.281	66° 18' 39"	-9.849	4.349	-29.701	292.525149
4-028	-42989.079	25576.753	1.146	333° 47' 34"	7.345	16.741	-8.611	-63.247795
4-012	-42988.051	25576.247	7.691	332° 26' 07"	1.028	-0.506	7.624	7.837472
4-011	-42981.233	25572.688	1.963	331° 13' 44"	6.818	-3.559	3.559	24.265262
							倍 面 積	386.675853
							面 積	193.3379265

現場名：弁天地区出来形確認測量

倍橫距法面積計算書

地番 点名	4-3 X	Y	距離	方向角	緯距	經距	倍橫距	倍面積
4-028	-42989.079	25576.753	18.281	246° 18' 39"	3.026	-1.464	-1.464	-4.430064
4-032	-42996.424	25560.012	18.519	240° 57' 32"	-7.345	-16.741	-19.669	144.468805
4-024	-43005.414	25543.821	37.453	137° 45' 18"	-8.990	-16.191	-52.601	472.882990
4-023	-43033.140	25569.001	33.863	336° 17' 01"	-27.726	25.180	-43.612	1209.186312
4-030	-43002.137	25555.381	24.942	66° 17' 02"	31.003	-13.620	-32.052	-993.708156
4-029	-42992.105	25578.217	3.362	334° 10' 55"	10.032	22.836	-22.836	-229.090752
							倍面積	599.309135
							面積	299.6545675

現場名: 弁天地区出来形確認測量

倍橫距法面積計算書

地番 点名	X	Y	距離	方向角	緯距	經距	倍橫距	倍面積
4-029	-42992.105	25578.217	24.942	246° 17' 02"	5.569	-2.709	-2.709	-15.086421
4-030	-43002.137	25555.381	33.863	156° 17' 01"	-10.032	-22.836	-28.254	283.444128
4-023	-43033.140	25569.001	0.227	137° 40' 32"	-31.003	13.620	-37.470	1161.682410
4-022	-43033.308	25569.154	7.747	125° 23' 05"	-0.168	0.153	-23.697	3.981096
4-006	-43037.794	25575.470	3.001	82° 43' 33"	-4.486	6.316	-17.228	77.284808
4-005	-43037.414	25578.447	2.459	42° 33' 38"	0.380	2.977	-7.935	-3.015300
4-021	-43035.603	25580.110	2.512	45° 44' 31"	1.811	1.663	-3.295	-5.967245
4-020	-43033.850	25581.909	2.491	48° 41' 42"	1.753	1.799	0.167	0.292751
4-019	-43032.206	25583.780	2.495	51° 26' 39"	1.644	1.871	3.837	6.308028
4-018	-43030.651	25585.731	2.495	54° 28' 32"	1.555	1.951	7.659	11.909745
4-017	-43029.201	25587.762	2.494	57° 26' 39"	1.450	2.031	11.641	16.879450
4-016	-43027.859	25589.864	1.998	60° 03' 34"	1.342	2.102	15.774	21.168708
4-004	-43026.862	25591.595	3.000	19° 17' 11"	0.997	1.731	19.607	19.548179
4-003	-43024.030	25592.586	18.592	336° 20' 39"	2.832	0.991	22.329	63.235728
4-015	-43007.000	25585.126	4.243	336° 12' 07"	17.030	-7.460	15.860	270.095800
4-014	-43003.118	25583.414	5.986	335° 26' 20"	3.882	-1.712	6.688	25.962816
4-013	-42997.674	25580.926	6.193	334° 03' 35"	5.444	-2.488	2.488	13.544672
							倍面積	1951.269353
							面積	975.6346765

;

地番 点名	4-5 X	Y	距離	方向角	緯距	經距	倍橫距	倍面積
4-032	-42996.424	25560.012	10.766	336° 10' 31"	8.990	16.191	16.191	145.557090
4-034	-42986.575	25555.663	0.813	243° 24' 12"	9.849	-4.349	28.033	276.097017
4-033	-42986.939	25554.936	21.227	241° 00' 24"	-0.364	-0.727	22.957	-8.356348
4-025	-42997.228	25536.369	11.070	137° 41' 14"	-10.289	-18.567	3.663	-37.688607
4-024	-43005.414	25543.821	18.519	60° 57' 32"	-8.186	7.452	-7.452	61.002072
							倍 面 積	436.611224
							面 積	218.3056120

現場名: 弁天地区出来形確認測量

倍橫距法面積計算書

地番 点名	4-7	X	Y	距離	方向角	緯距	經距	倍橫距	倍面積
4-025		-42997.228	25536.369	21.227	61° 00' 24"	-13.416	12.192	12.192	-163.567872
4-033		-42986.939	25554.936	17.700	336° 10' 30"	10.289	18.567	42.951	441.922839
4-026		-42970.747	25547.786	25.114	246° 12' 51"	16.192	-7.150	54.368	880.326656
4-008		-42980.876	25524.805	3.002	192° 04' 24"	-10.129	-22.981	24.237	-245.496573
4-007		-42983.812	25524.177	18.128	137° 44' 11"	-2.936	-0.628	0.628	-1.843808
								倍 面 積	911.341242
								面 積	455.6706210