
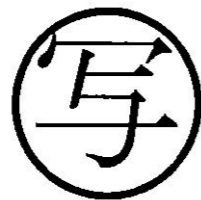
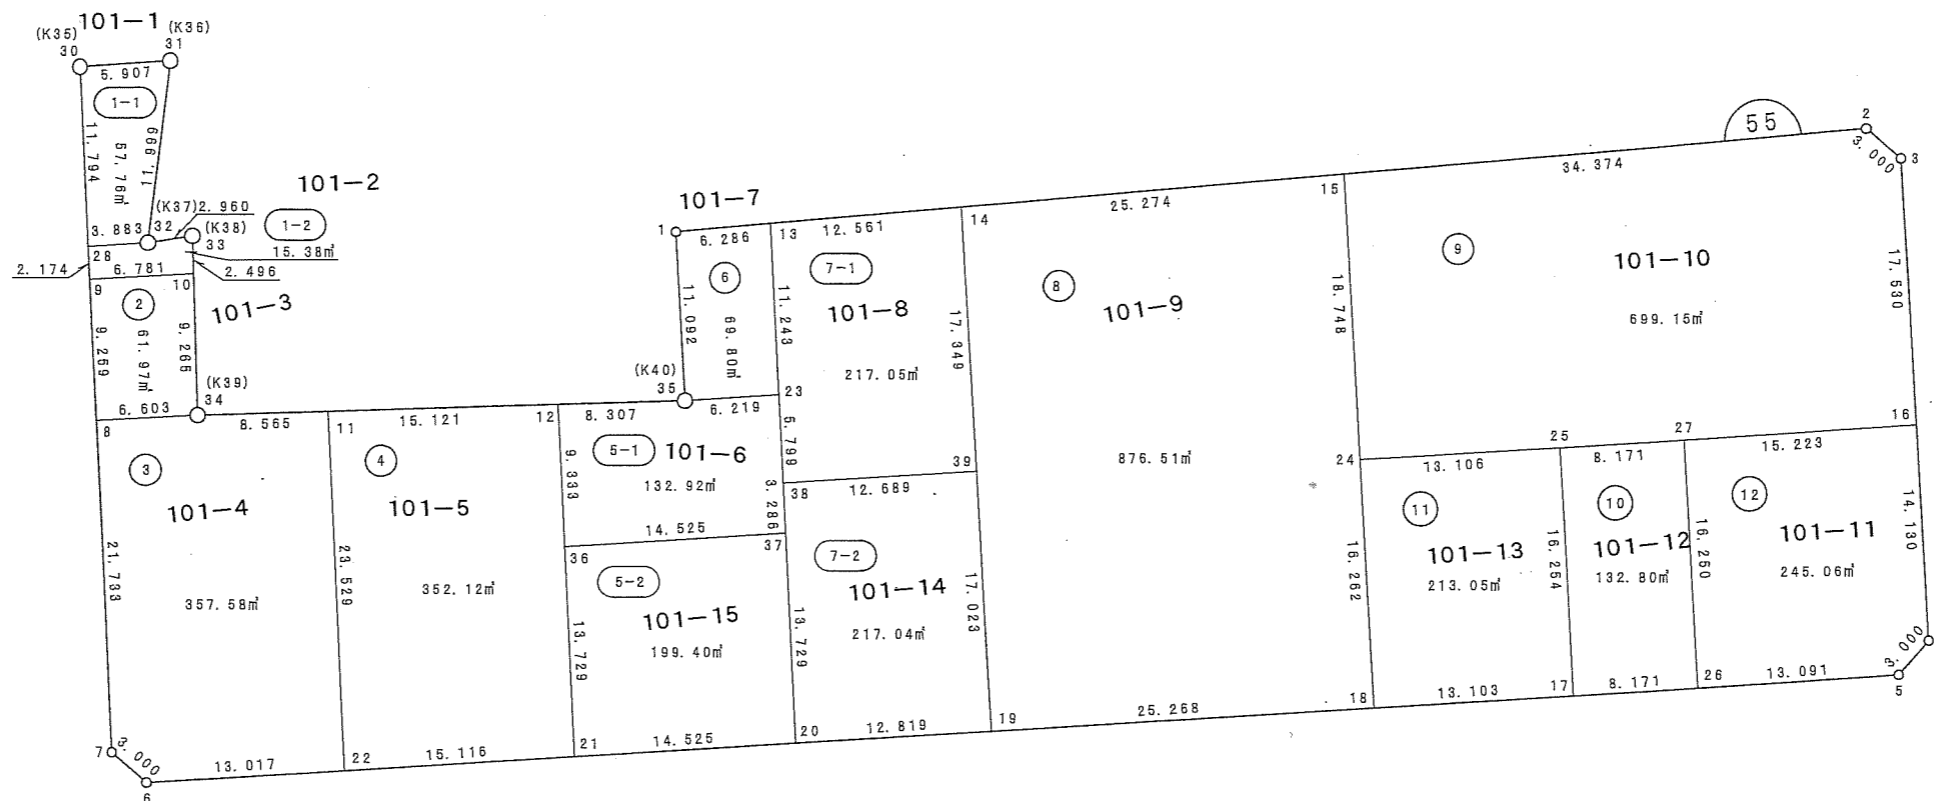


蘇我五丁目




(世界測地系)

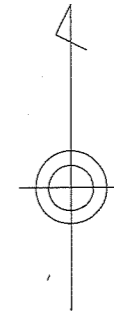

縮尺 1 : 500

蘇我五丁目




(世界測地系)

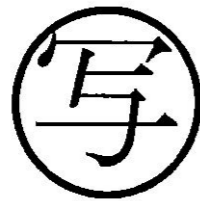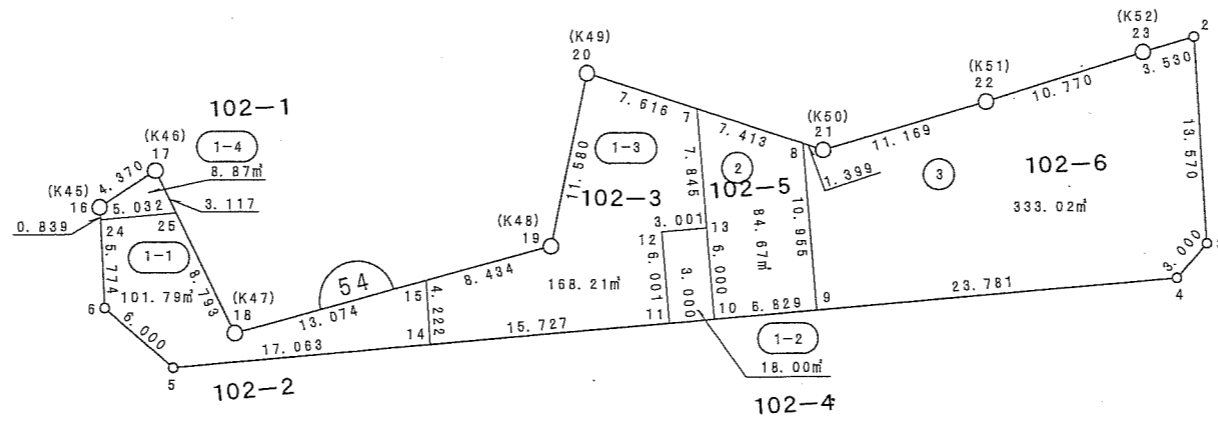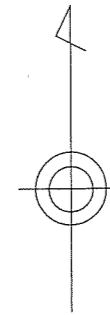

縮尺 1 : 500

蘇我五丁目




(世界測地系)

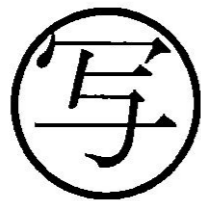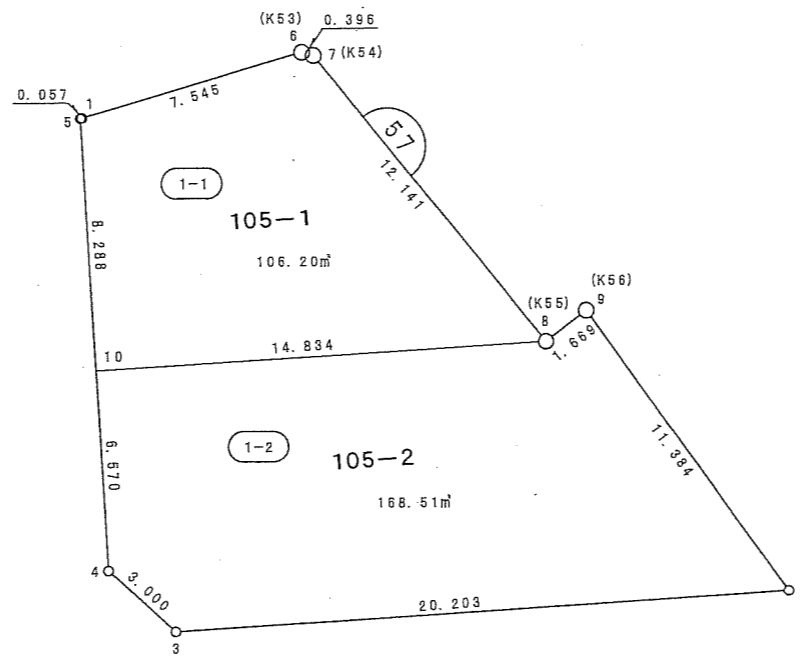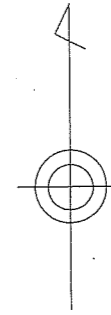

縮尺 1 : 250

蘇我五丁目

(世界測地系)

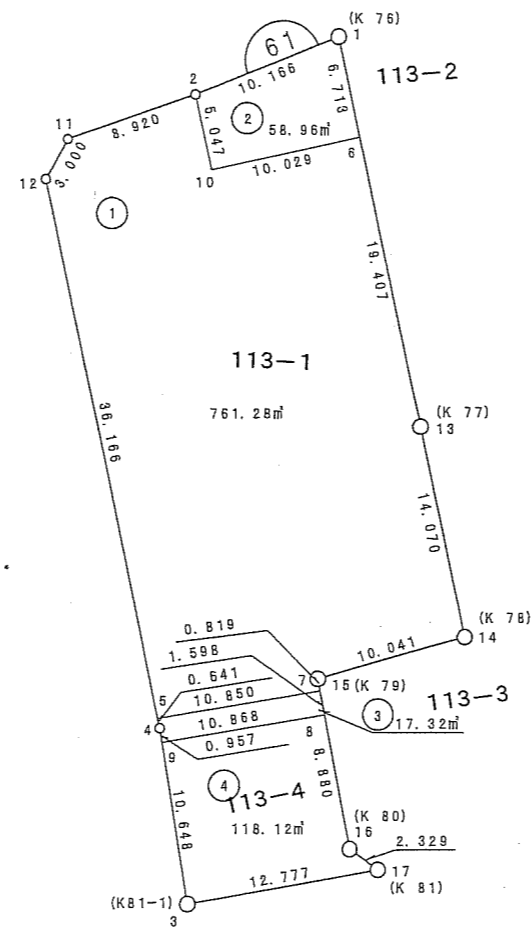
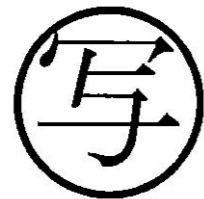
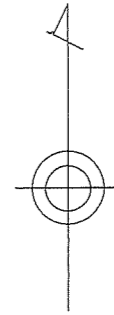


縮尺 1:500



蘇我五丁目

(世界測地系)

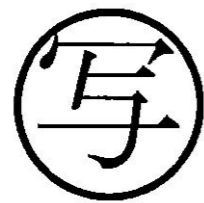
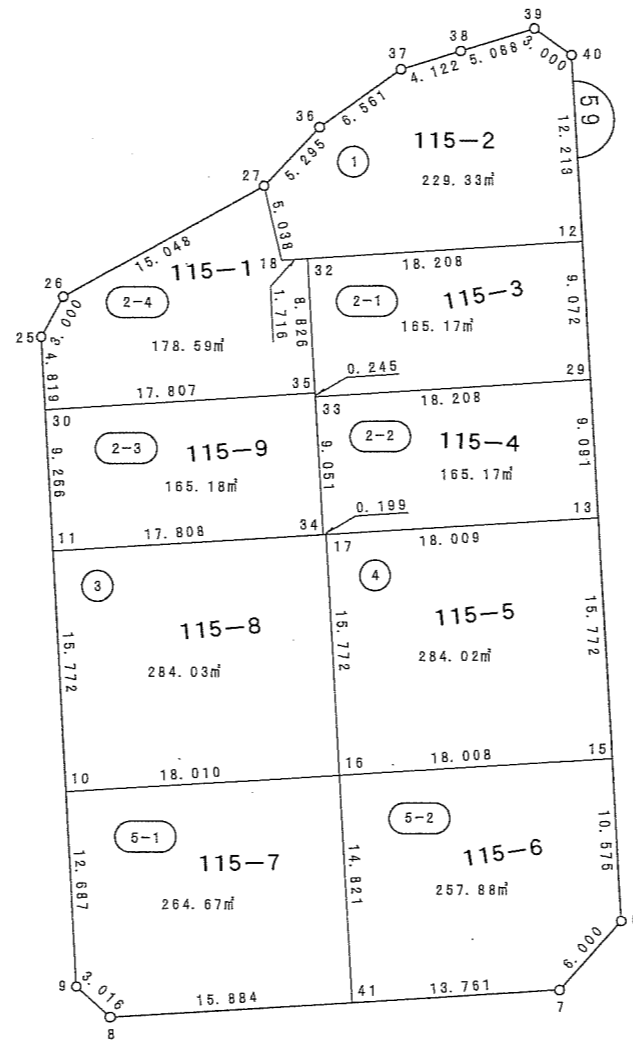
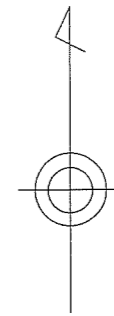


縮尺 1:500



蘇我五丁目

(世界測地系)

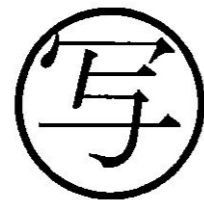
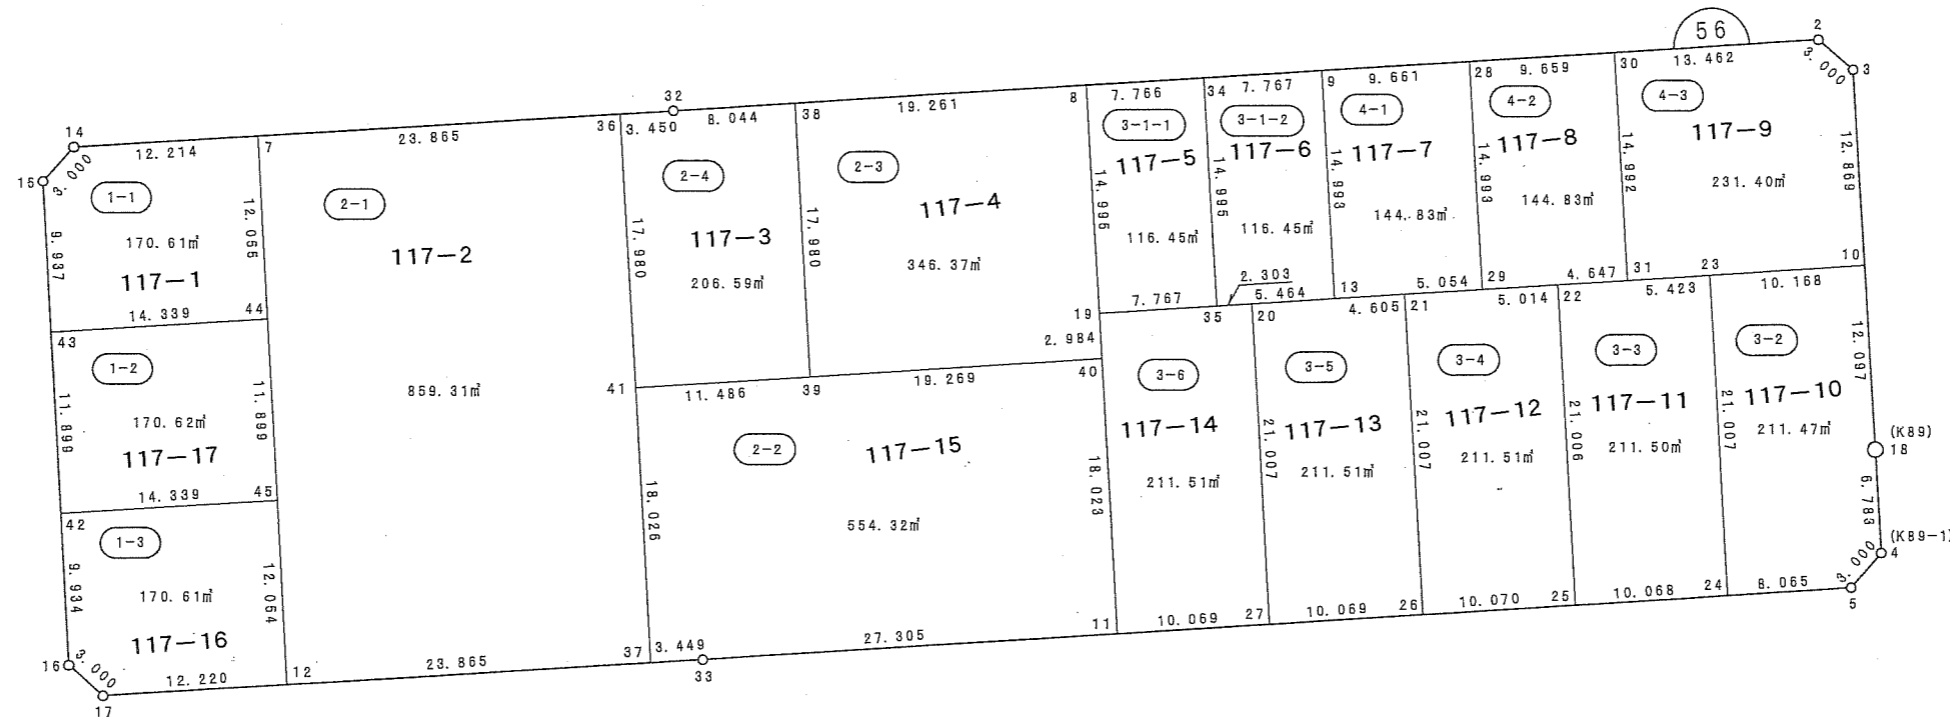
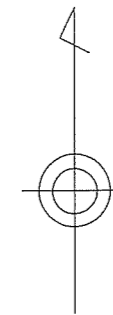


縮尺 1:500



蘇我五丁目




(世界測地系)

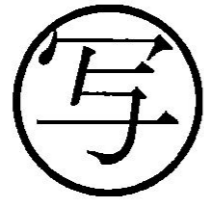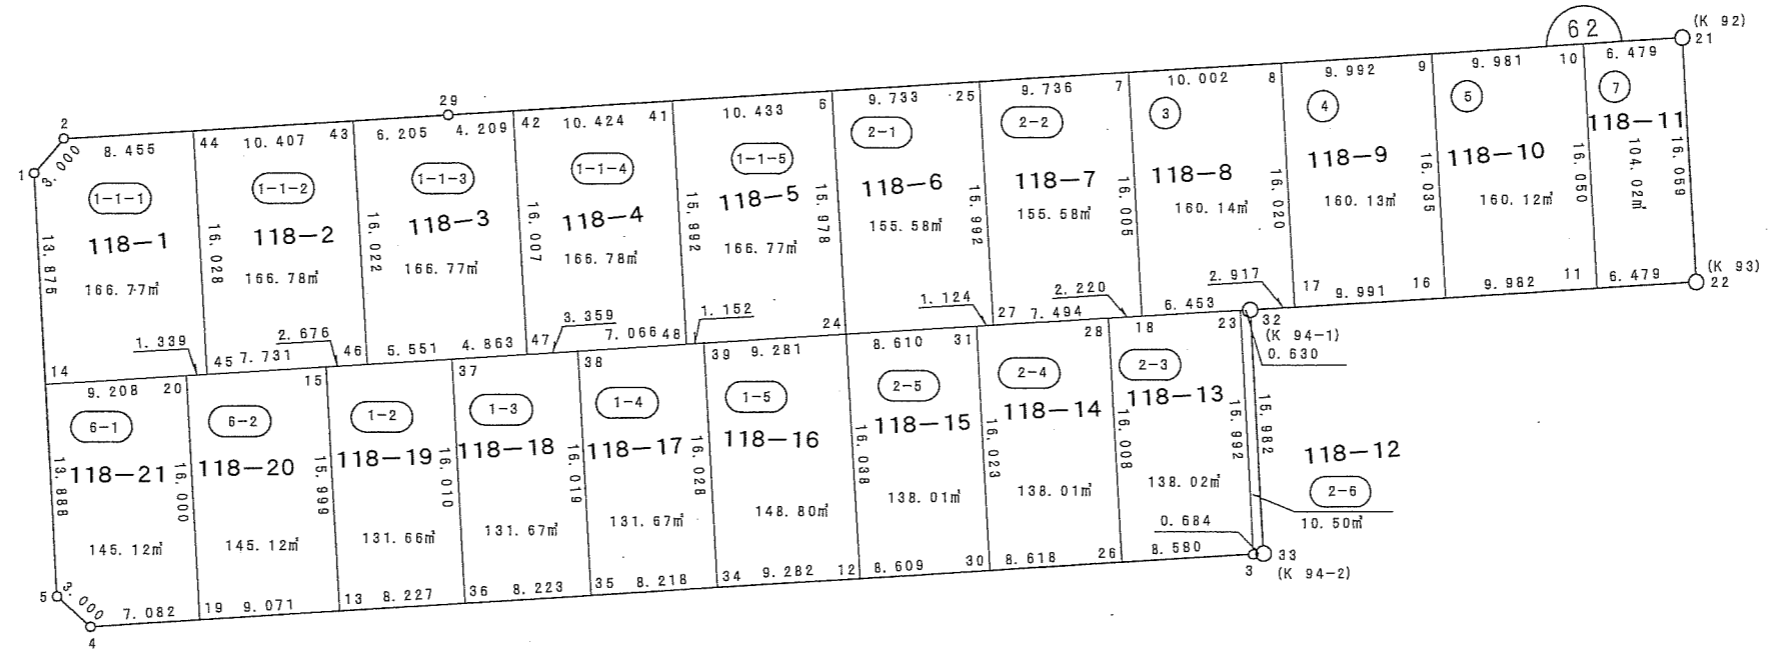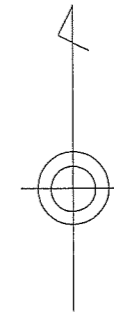

縮尺 1 : 500

蘇我五丁目




(世界測地系)

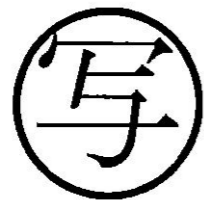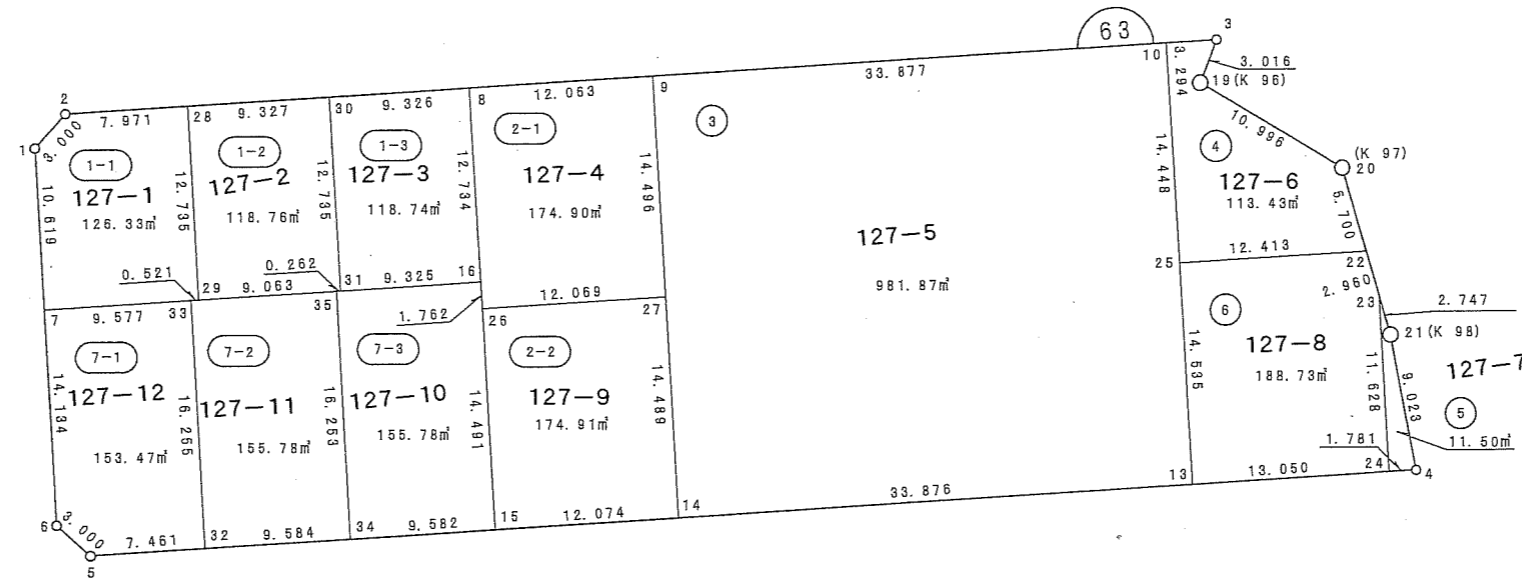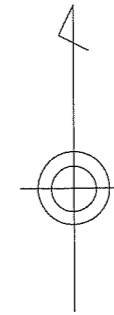

縮尺 1 : 500

蘇我五丁目



(世界測地系)

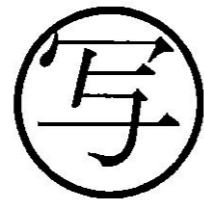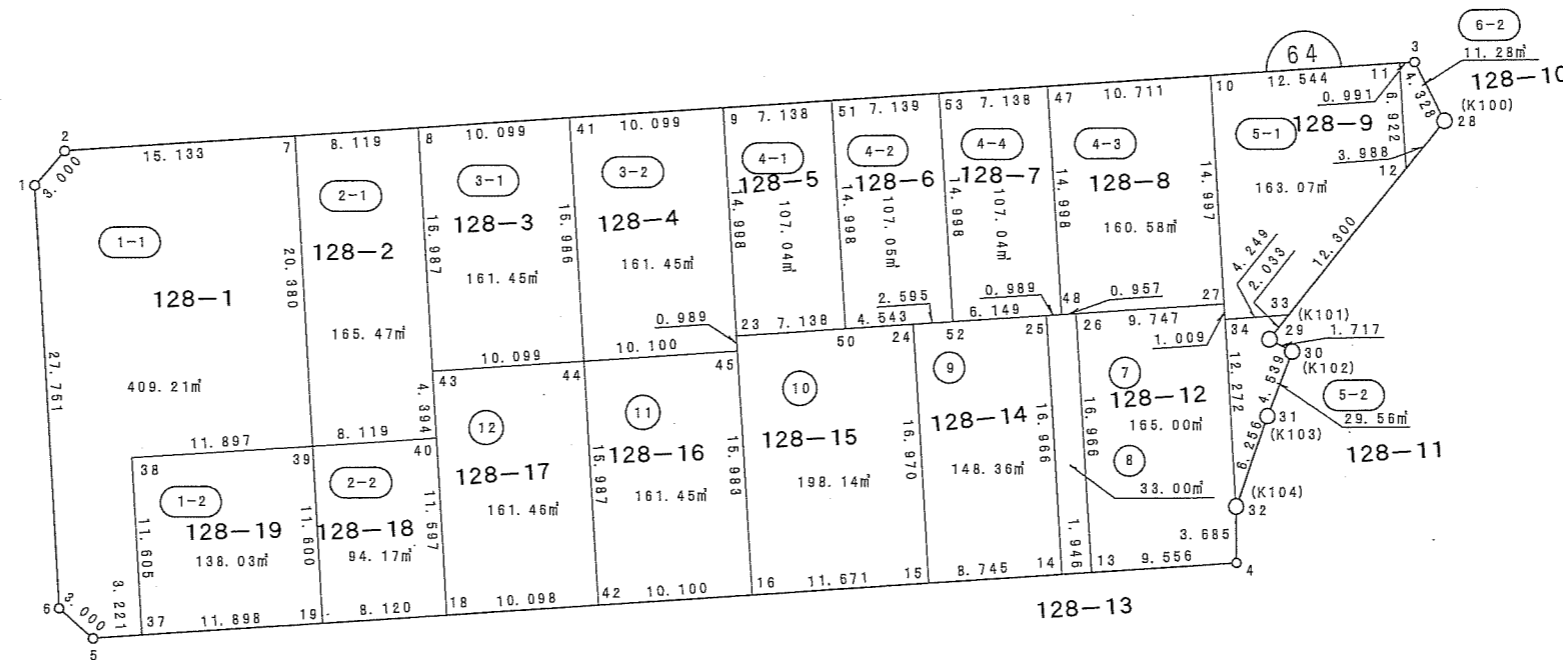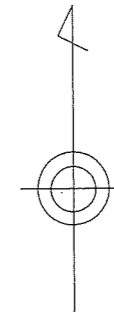

縮尺 1 : 500

蘇我五丁目




(世界測地系)

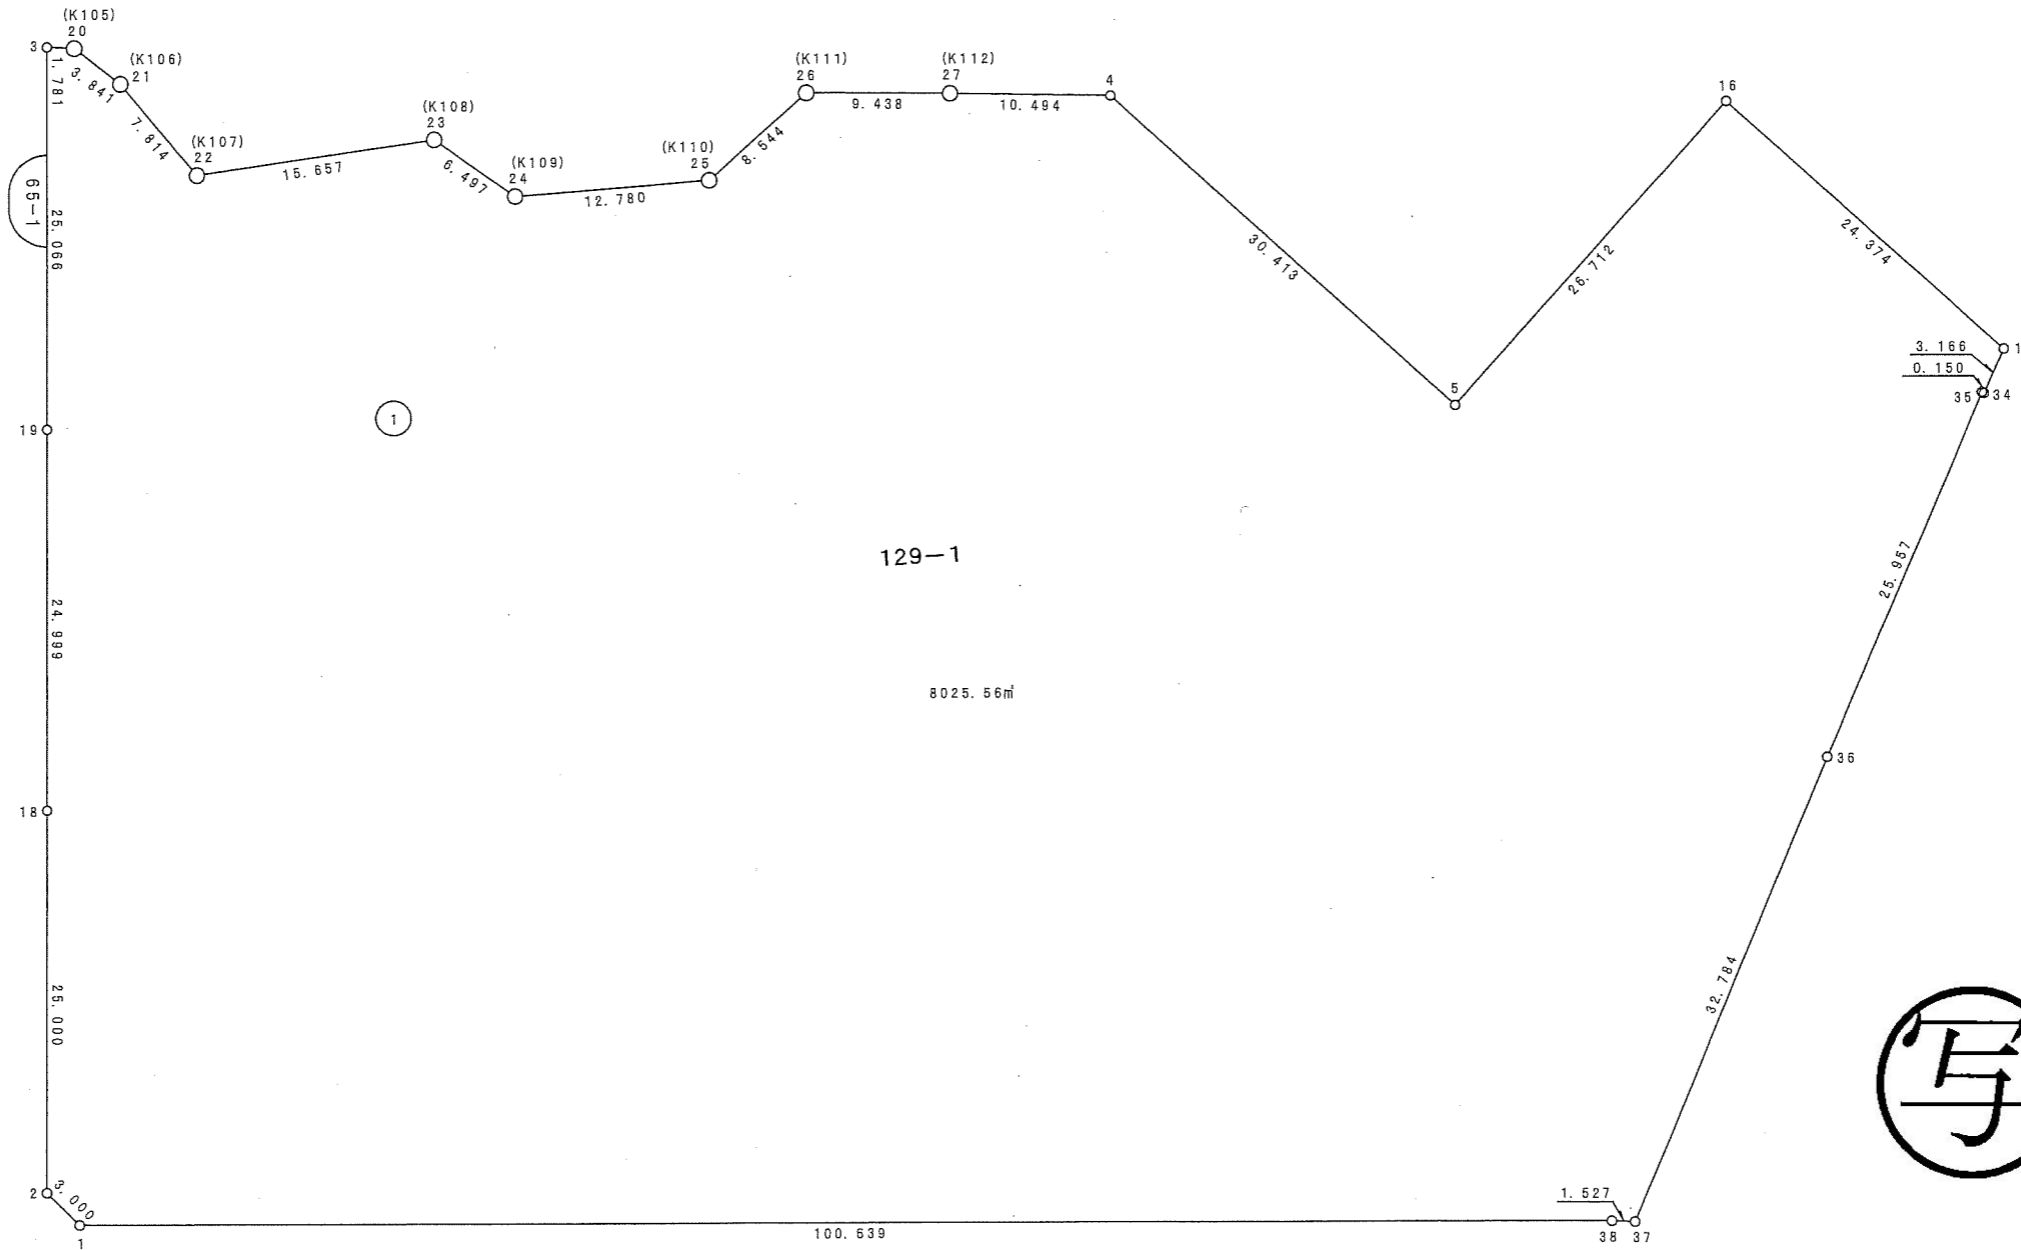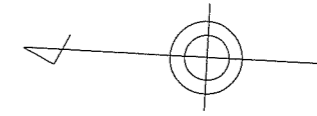

縮尺 1:500

蘇我五丁目




(世界測地系)

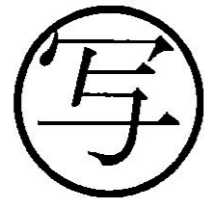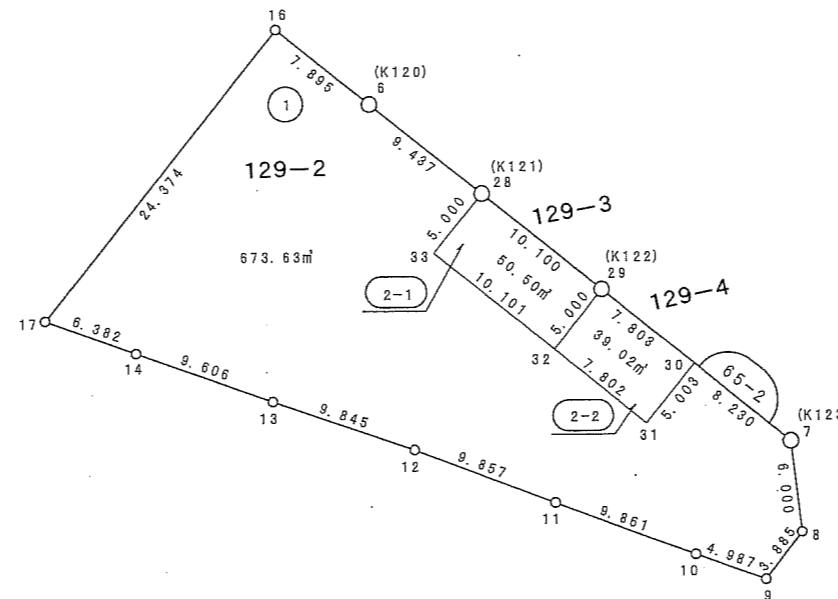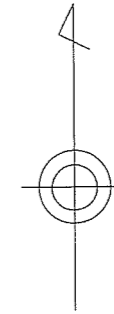

縮尺 1:500

蘇我五丁目




(世界測地系)

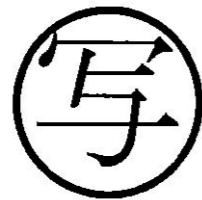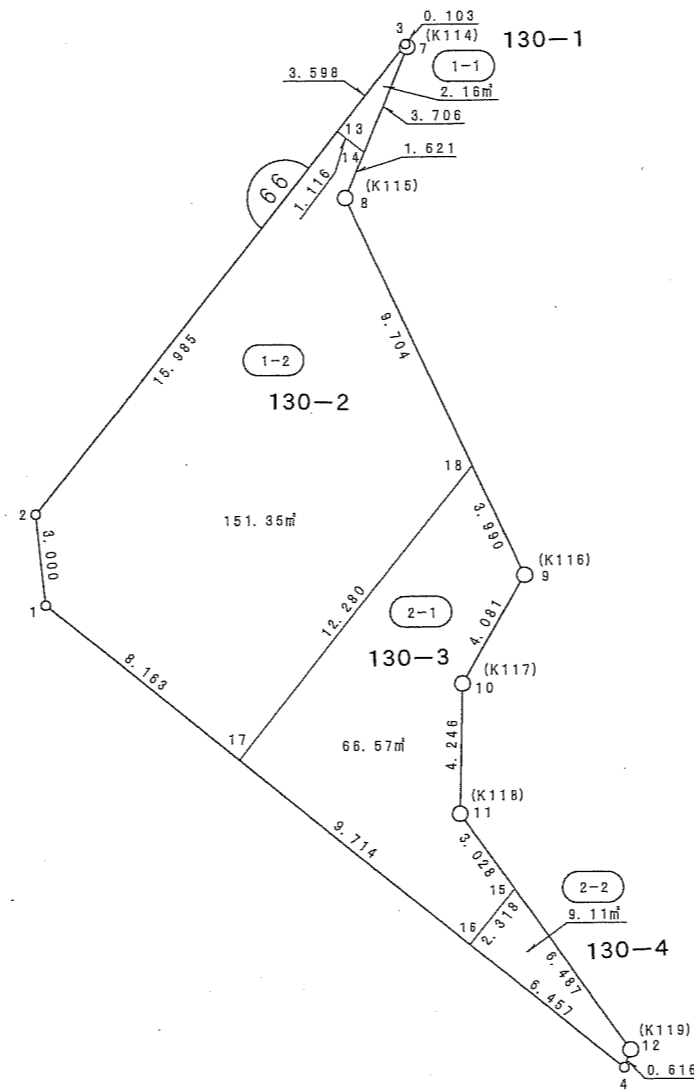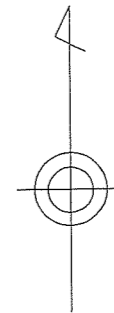

縮尺 1 : 250

蘇我五丁目

(世界測地系)

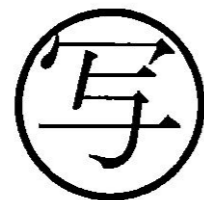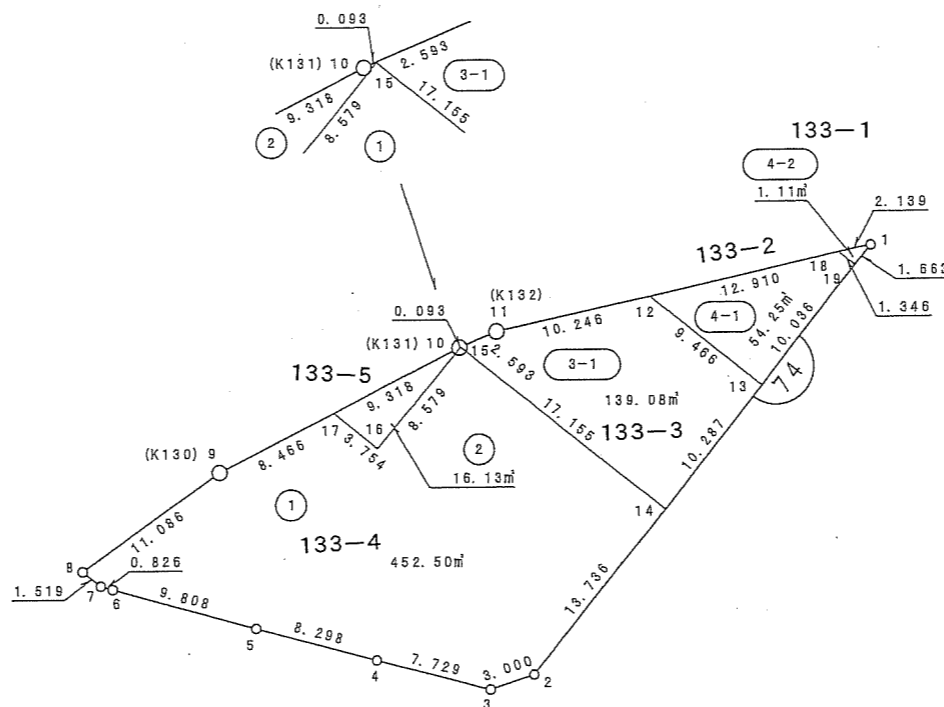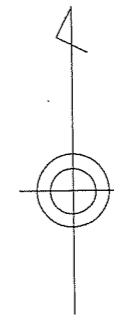




縮尺 1 : 500





蘇我五丁目




(世界測地系)

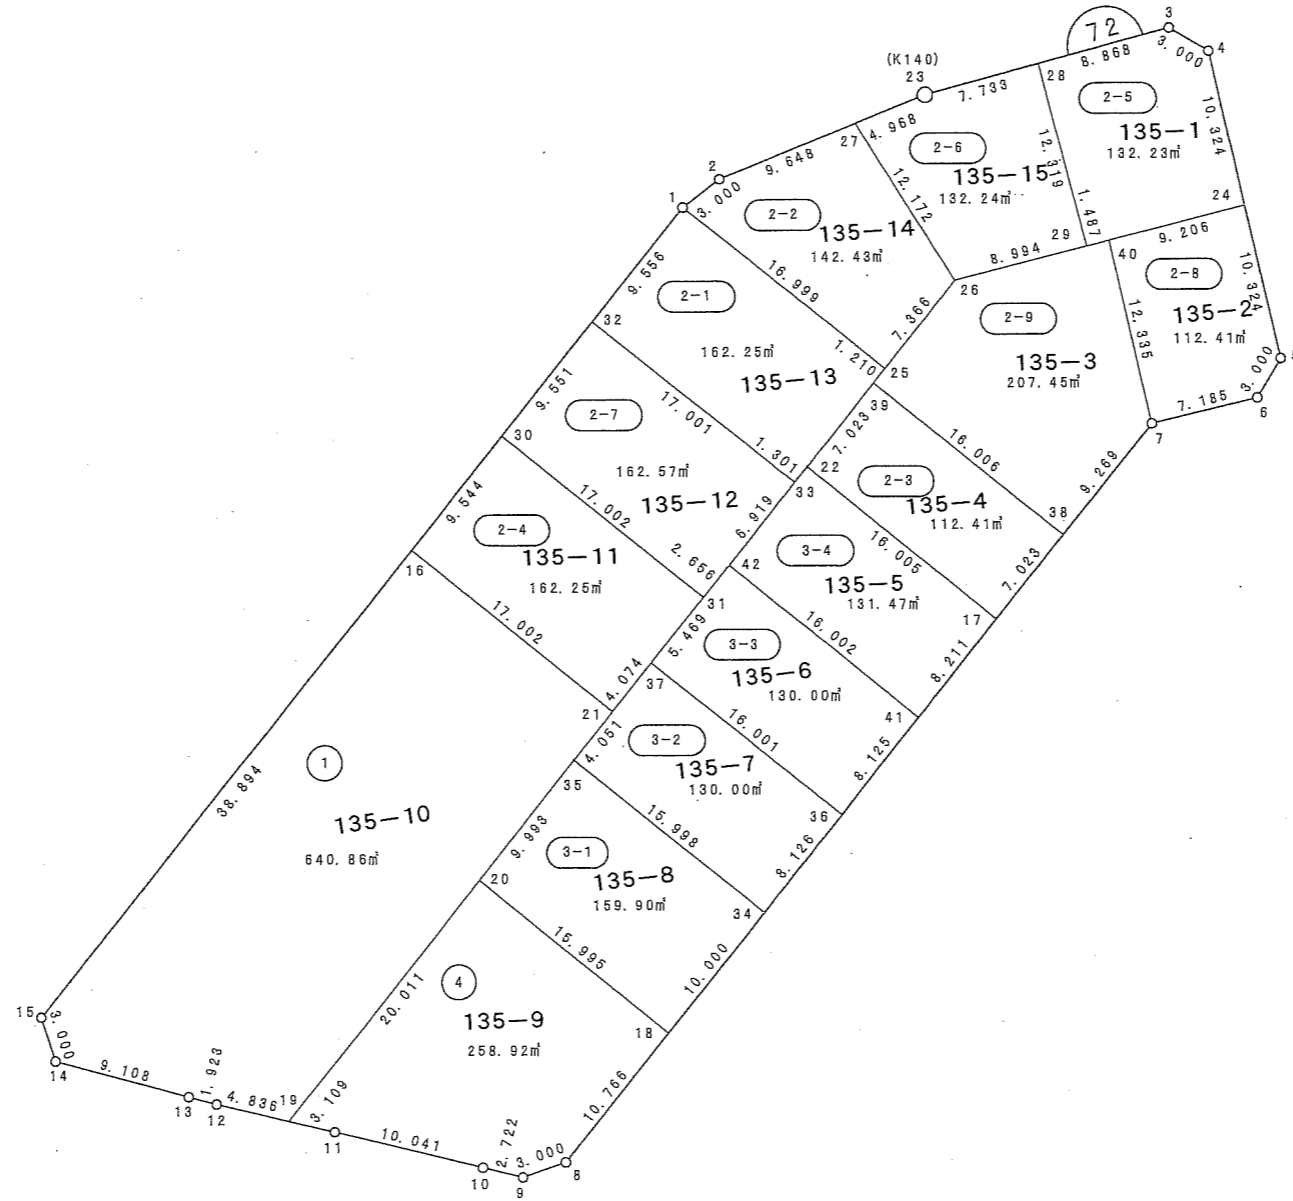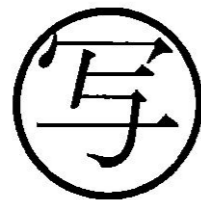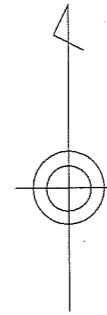

縮尺 1:500

蘇我五丁目




(世界測地系)

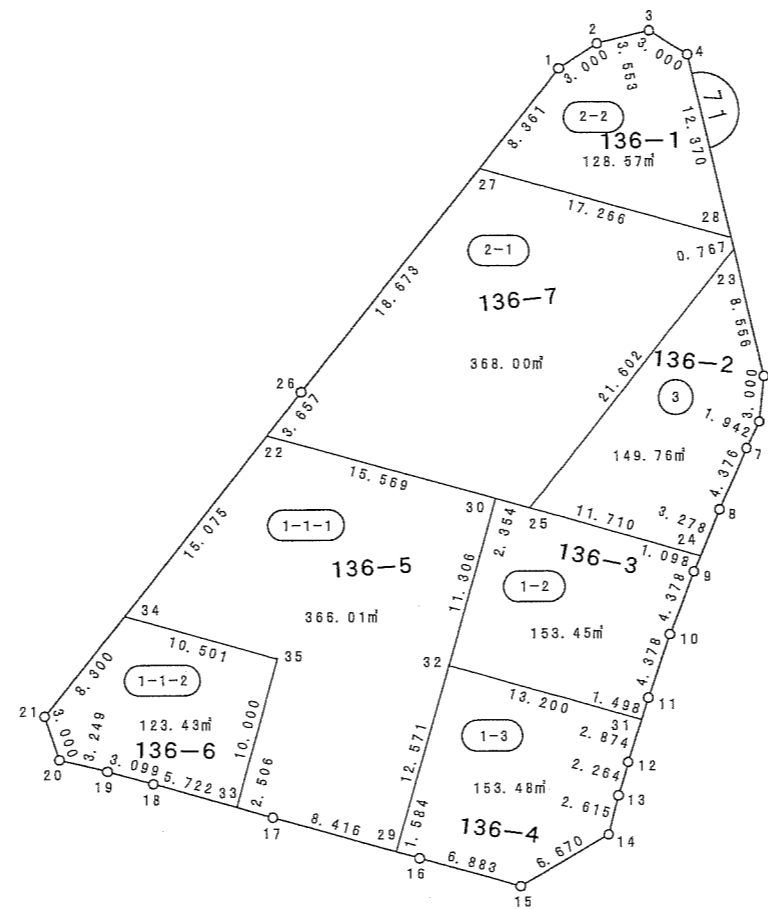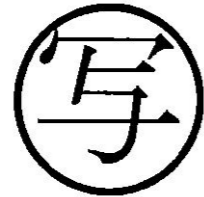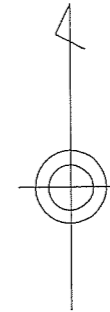

縮尺 1 : 500

蘇我五丁目




(世界測地系)

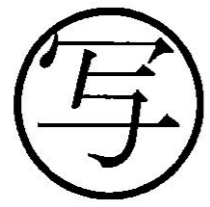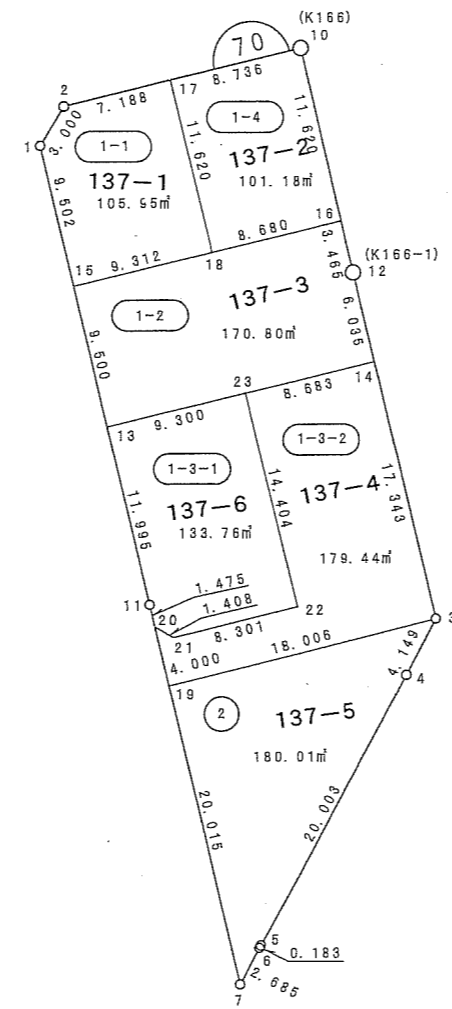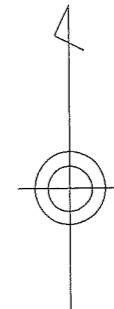

縮尺 1 : 500

蘇我五丁目




(世界測地系)

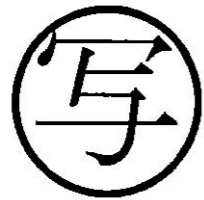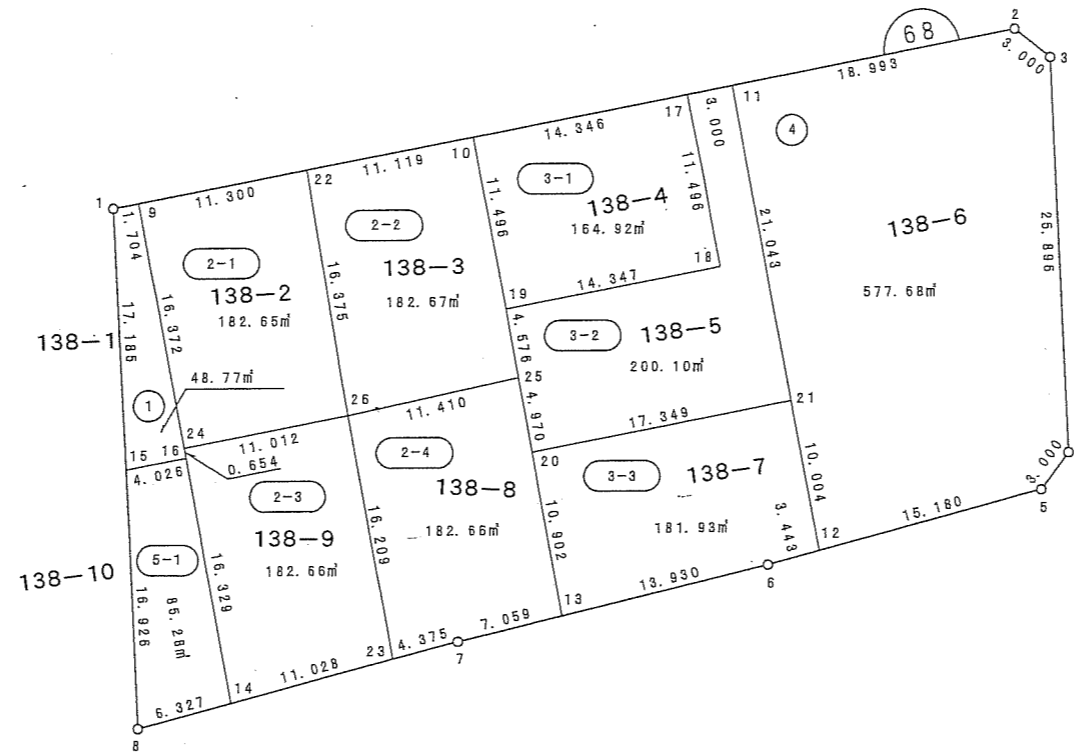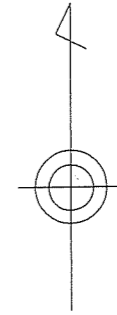

縮尺 1 : 500

蘇我五丁目




(世界測地系)

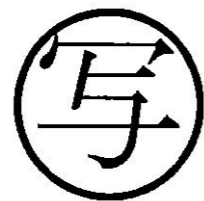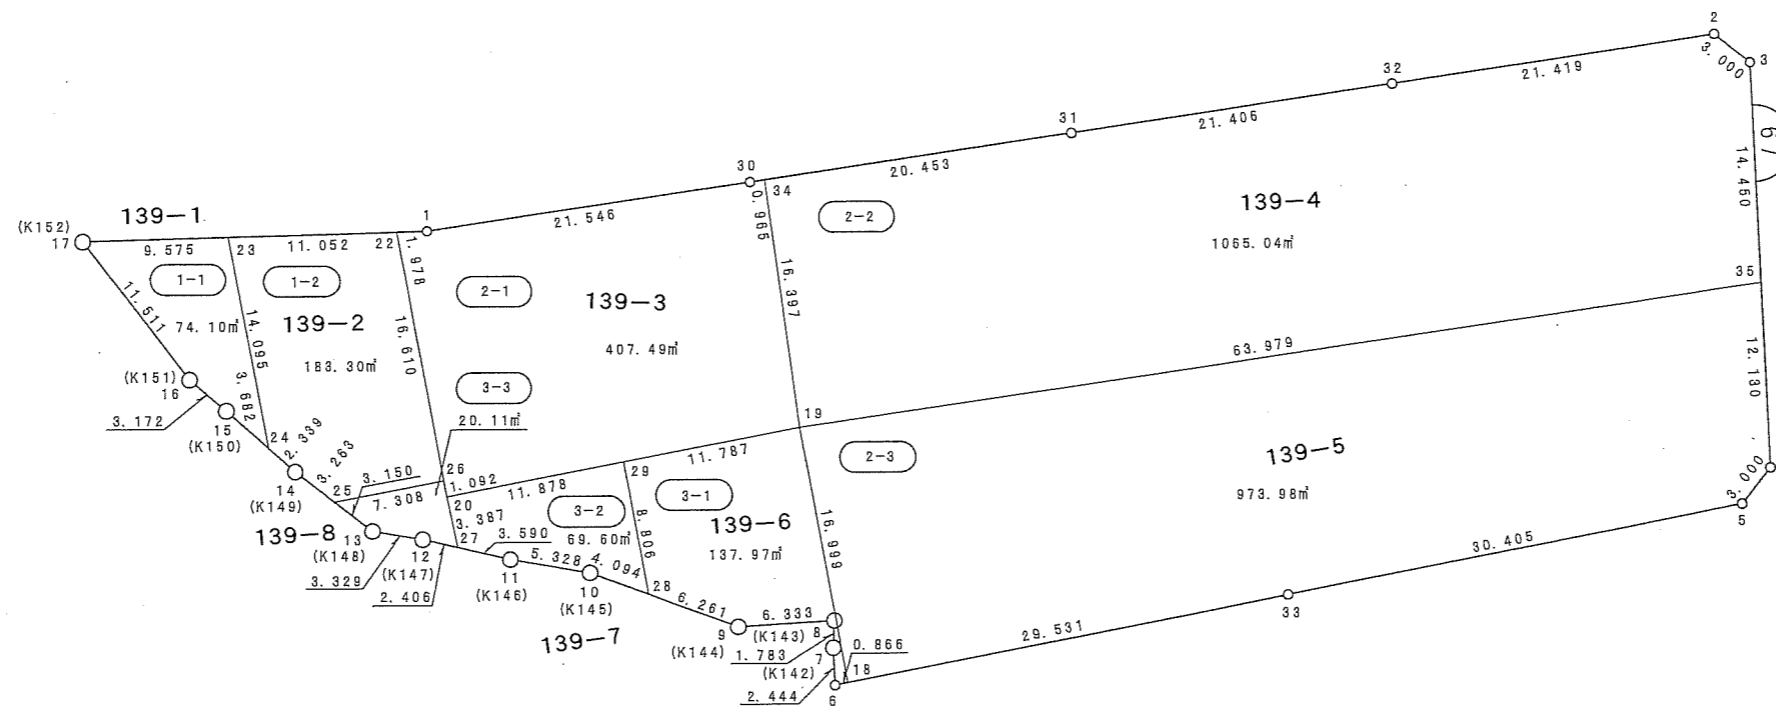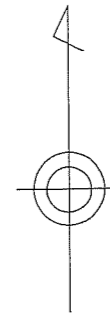

縮尺 1 : 500

蘇我五丁目

(世界測地系)

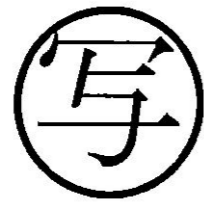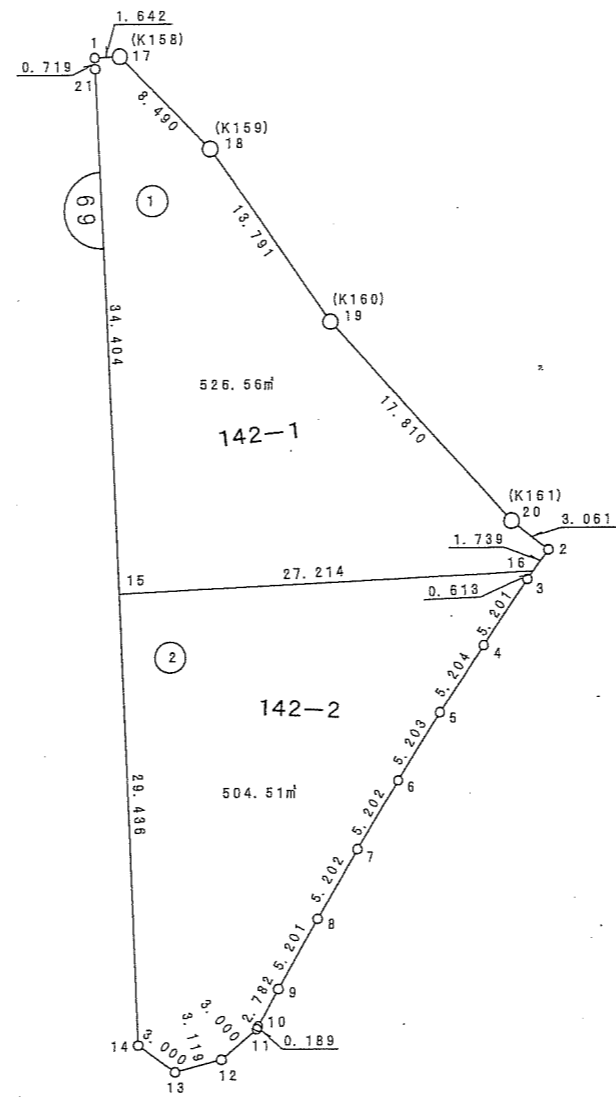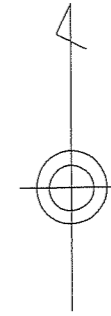

縮尺 1 : 500